


DECK PLAN

THE VISION YACHT

16 guests – 6 cabins / suite
and standard plus

CABIN CATEGORIES

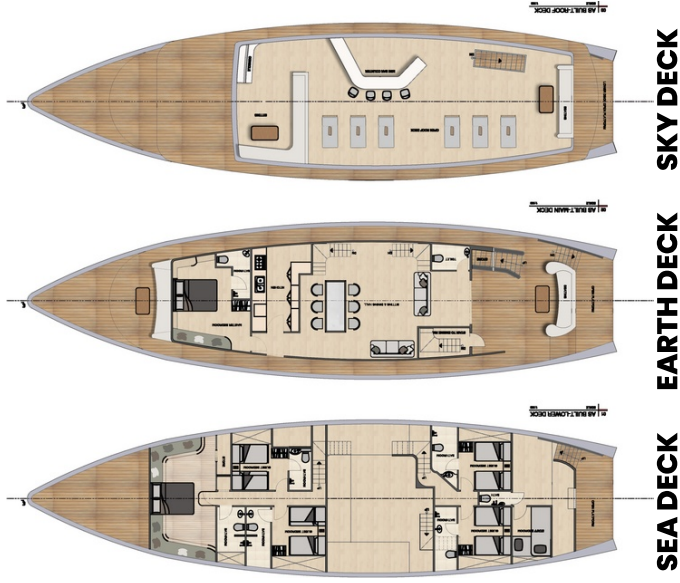

SOCIAL AREAS

SKY DECK



360 looking Area, sunbeds,
mini Bar.

EARTH DECK




earth suite cabin, kitchen, living room, two
seating areas outside.

SEA DECK




four cabins two on the left side,
two on the right side.

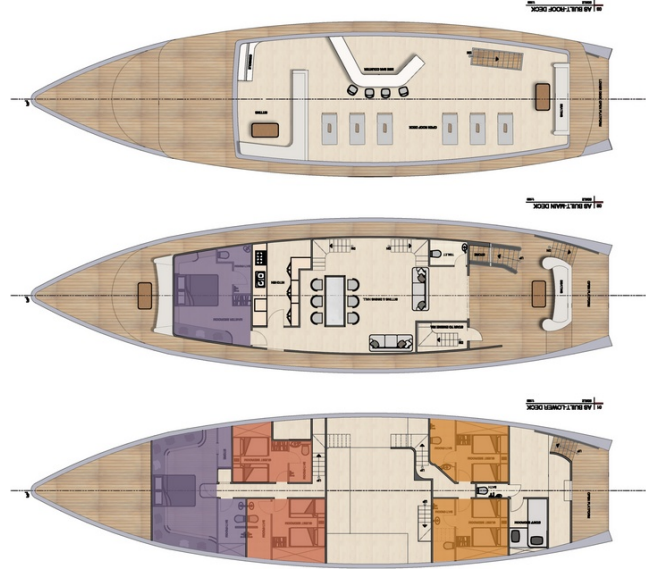


Standard Plus Cabin

Suite Cabin


Standard Plus Cabin

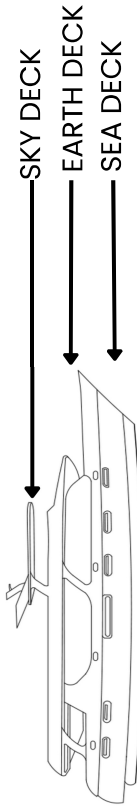

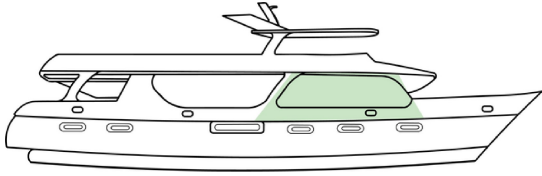


earth Cabin

- . 1 cabin on the earth deck
- . 1 king bed size
- . 1 sofa
- . 1 wardrobe
- . 1 toilet and shower
- . 1 desktop
- . 6 picture windows in the cabin
- . average area

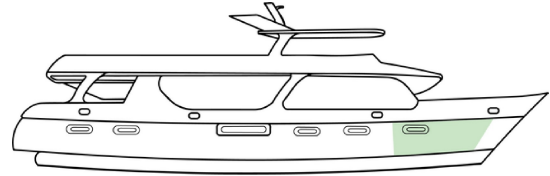


sea Suite

- . 1 cabin on the sea deck
- . 1 king bed size
- . 2 sofa
- . 1 wardrobe
- . 1 toilet and shower
- . 2 portholes in the cabin
- . average area

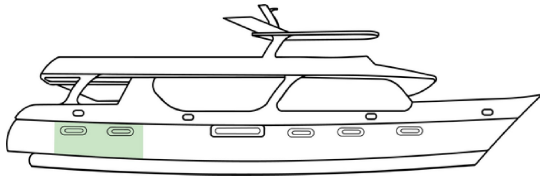


junior Cabin

- . 2 cabin on the sea deck
- . twin bed
- . 1 wardrobe
- . 1 toilet and shower per cabin
- . 2 porthole in the cabin
- . average area

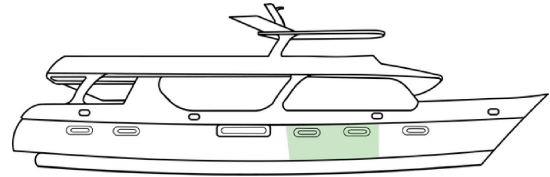


junior Cabin


- . 2 cabin on the sea deck
- . twin bed
- . 1 single bed on wall (if needed to open)
- . 1 wardrobe
- . 1 toilet and shower per cabin
- . 2 porthole in the cabin
- . average area

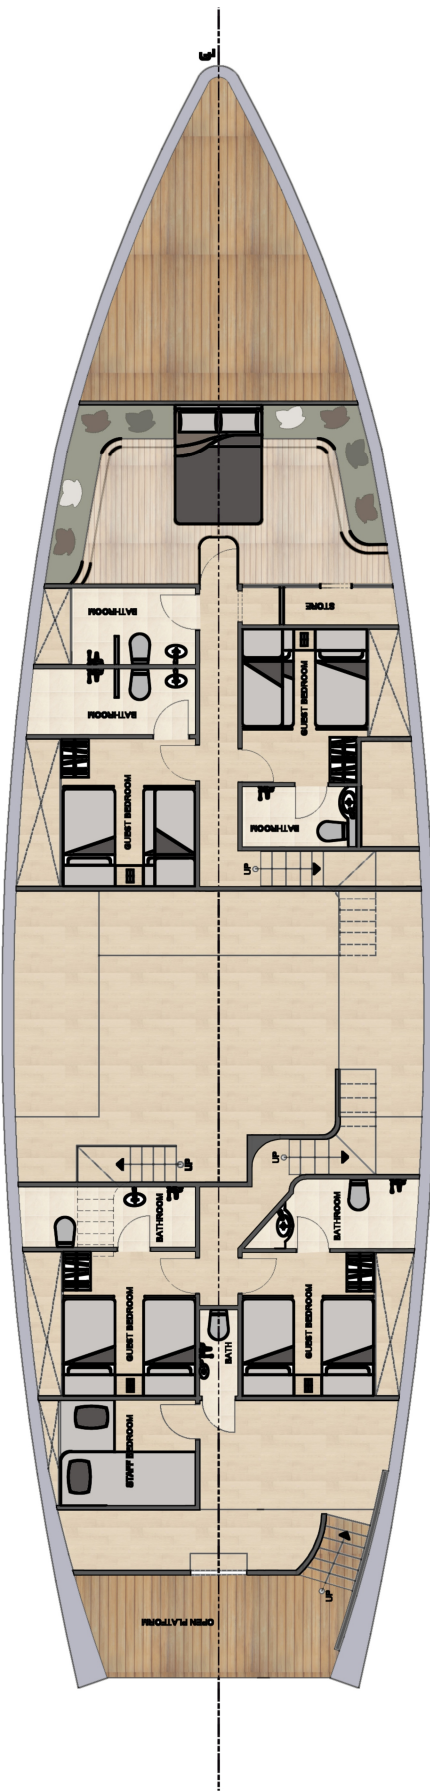


01 | AS BUILT-LOWER DECK
SCALE 1:500

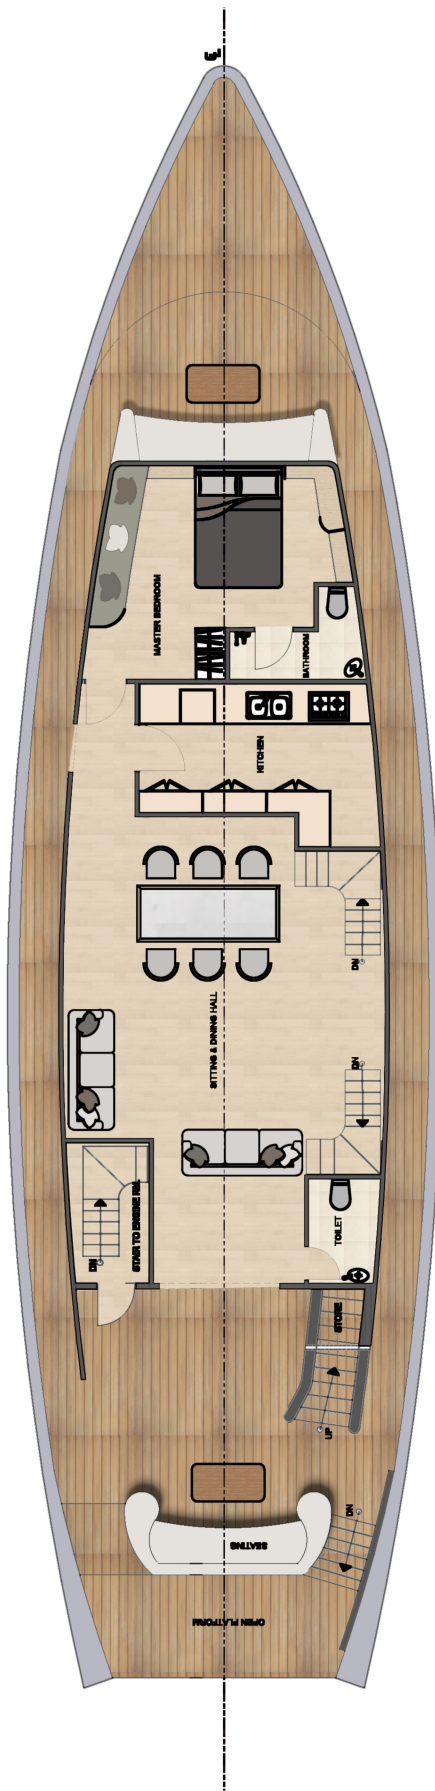


02 | AS BUILT-MAIN DECK
SCALE 1:500

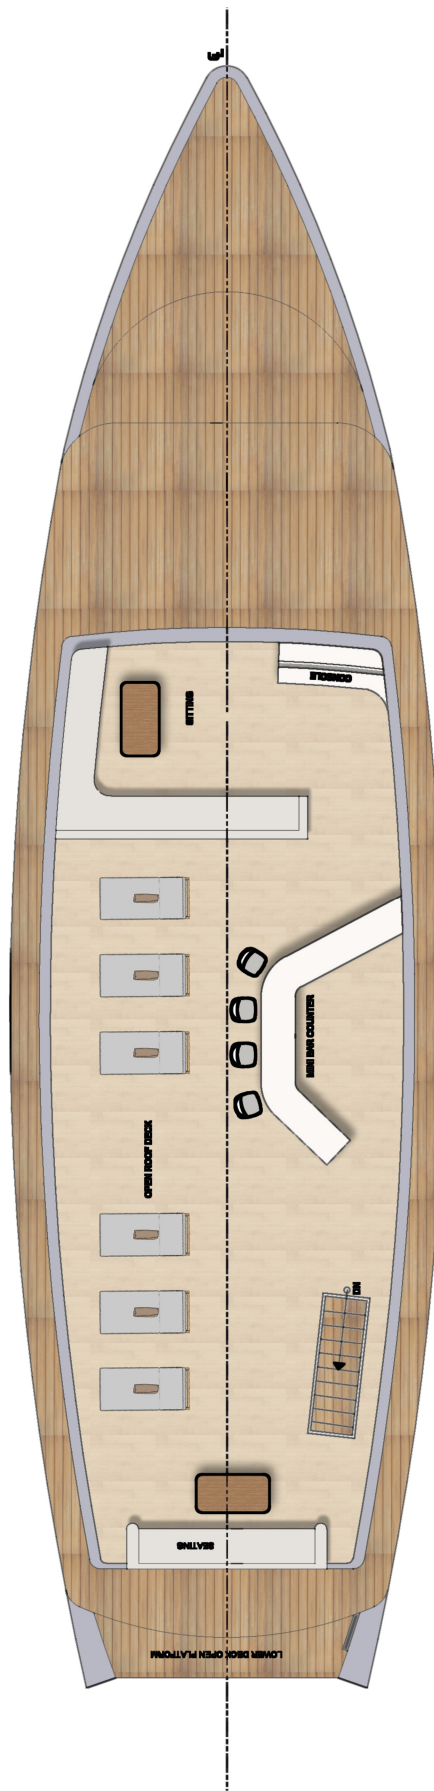


03 | AS BUILT-ROOF DECK
SCALE 1:500

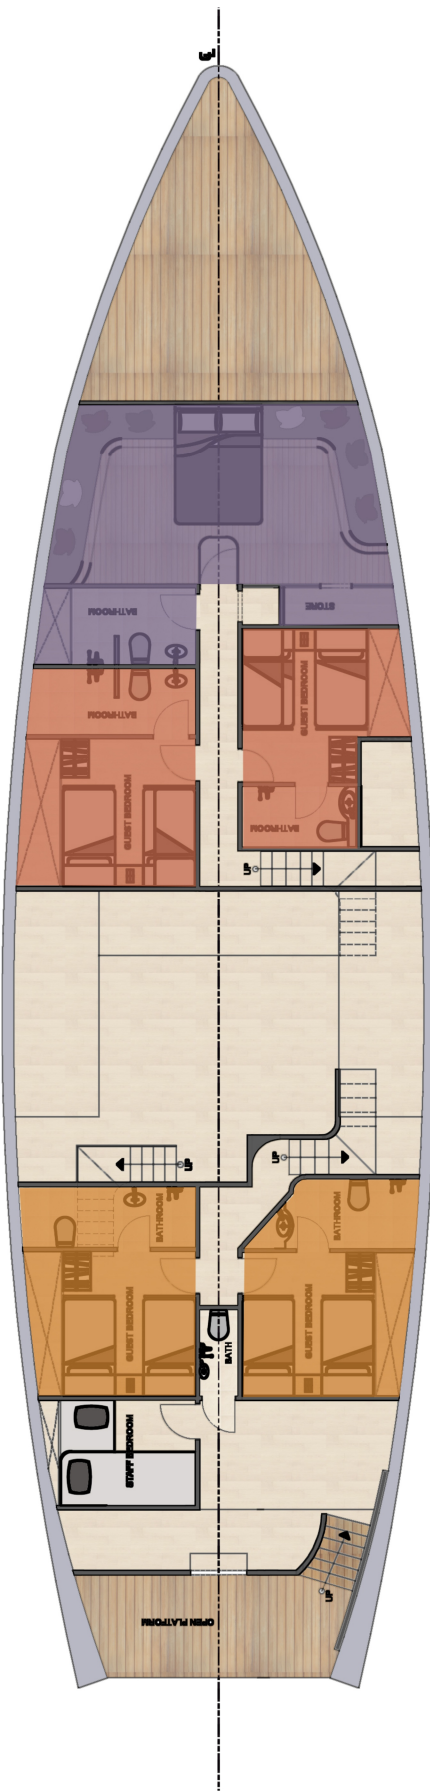

01 | AS BUILT-LOWER DECK
SCALE 1:500

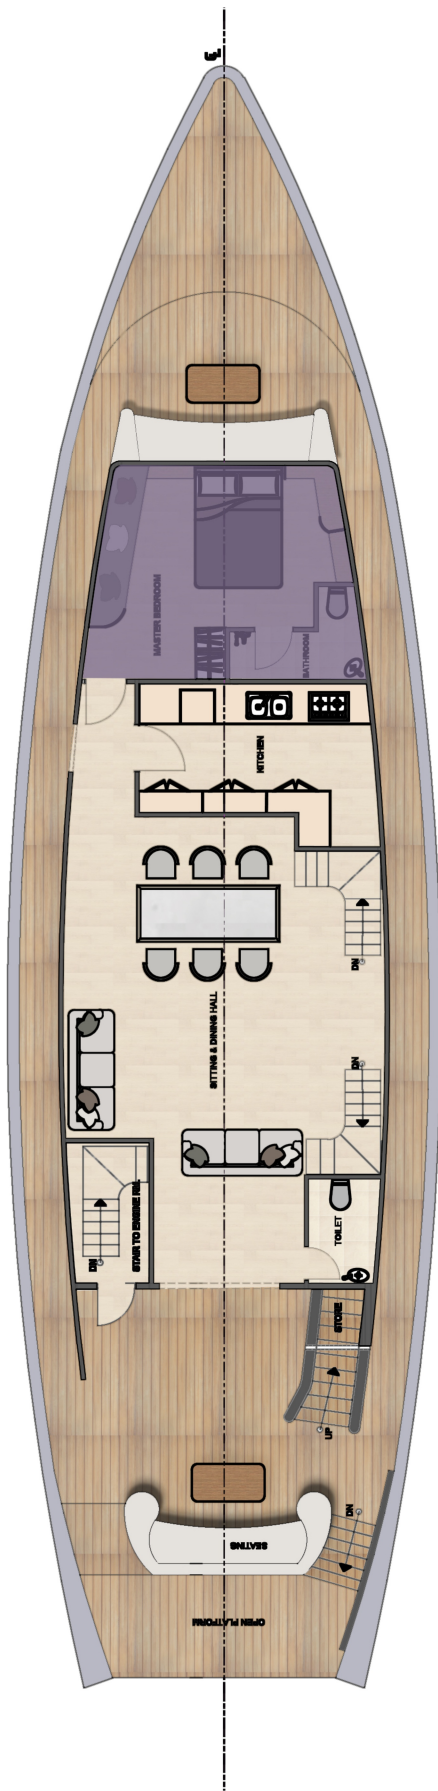

02 | AS BUILT-MAIN DECK
SCALE 1:500

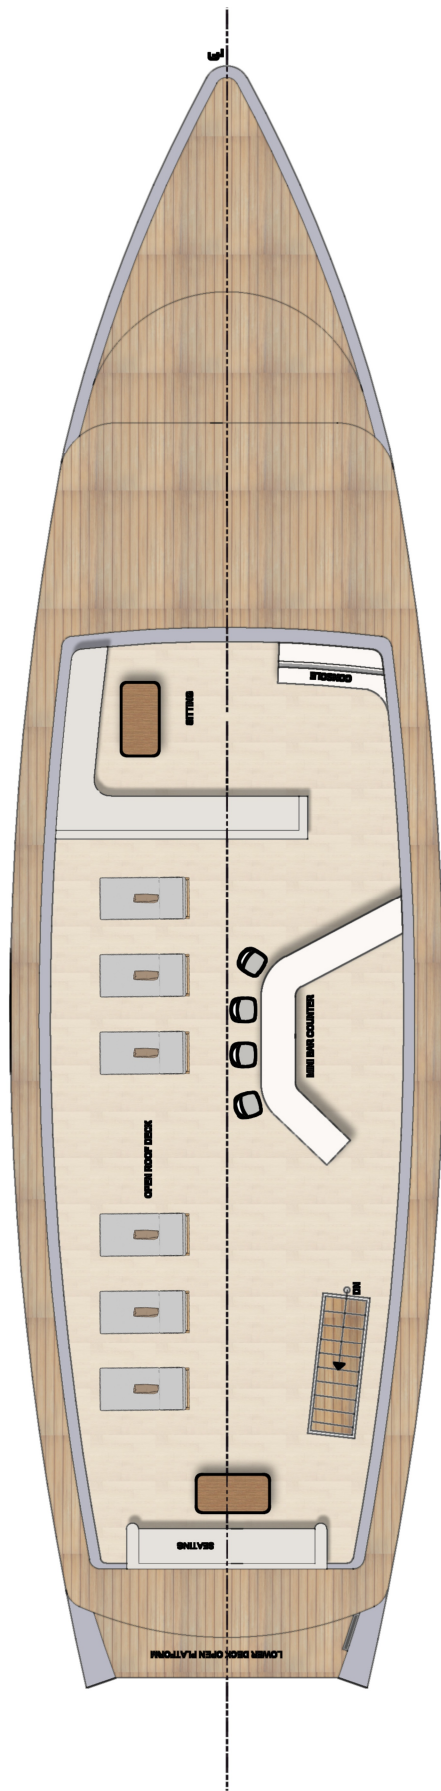

03 | AS BUILT-ROOF DECK
SCALE 1:500